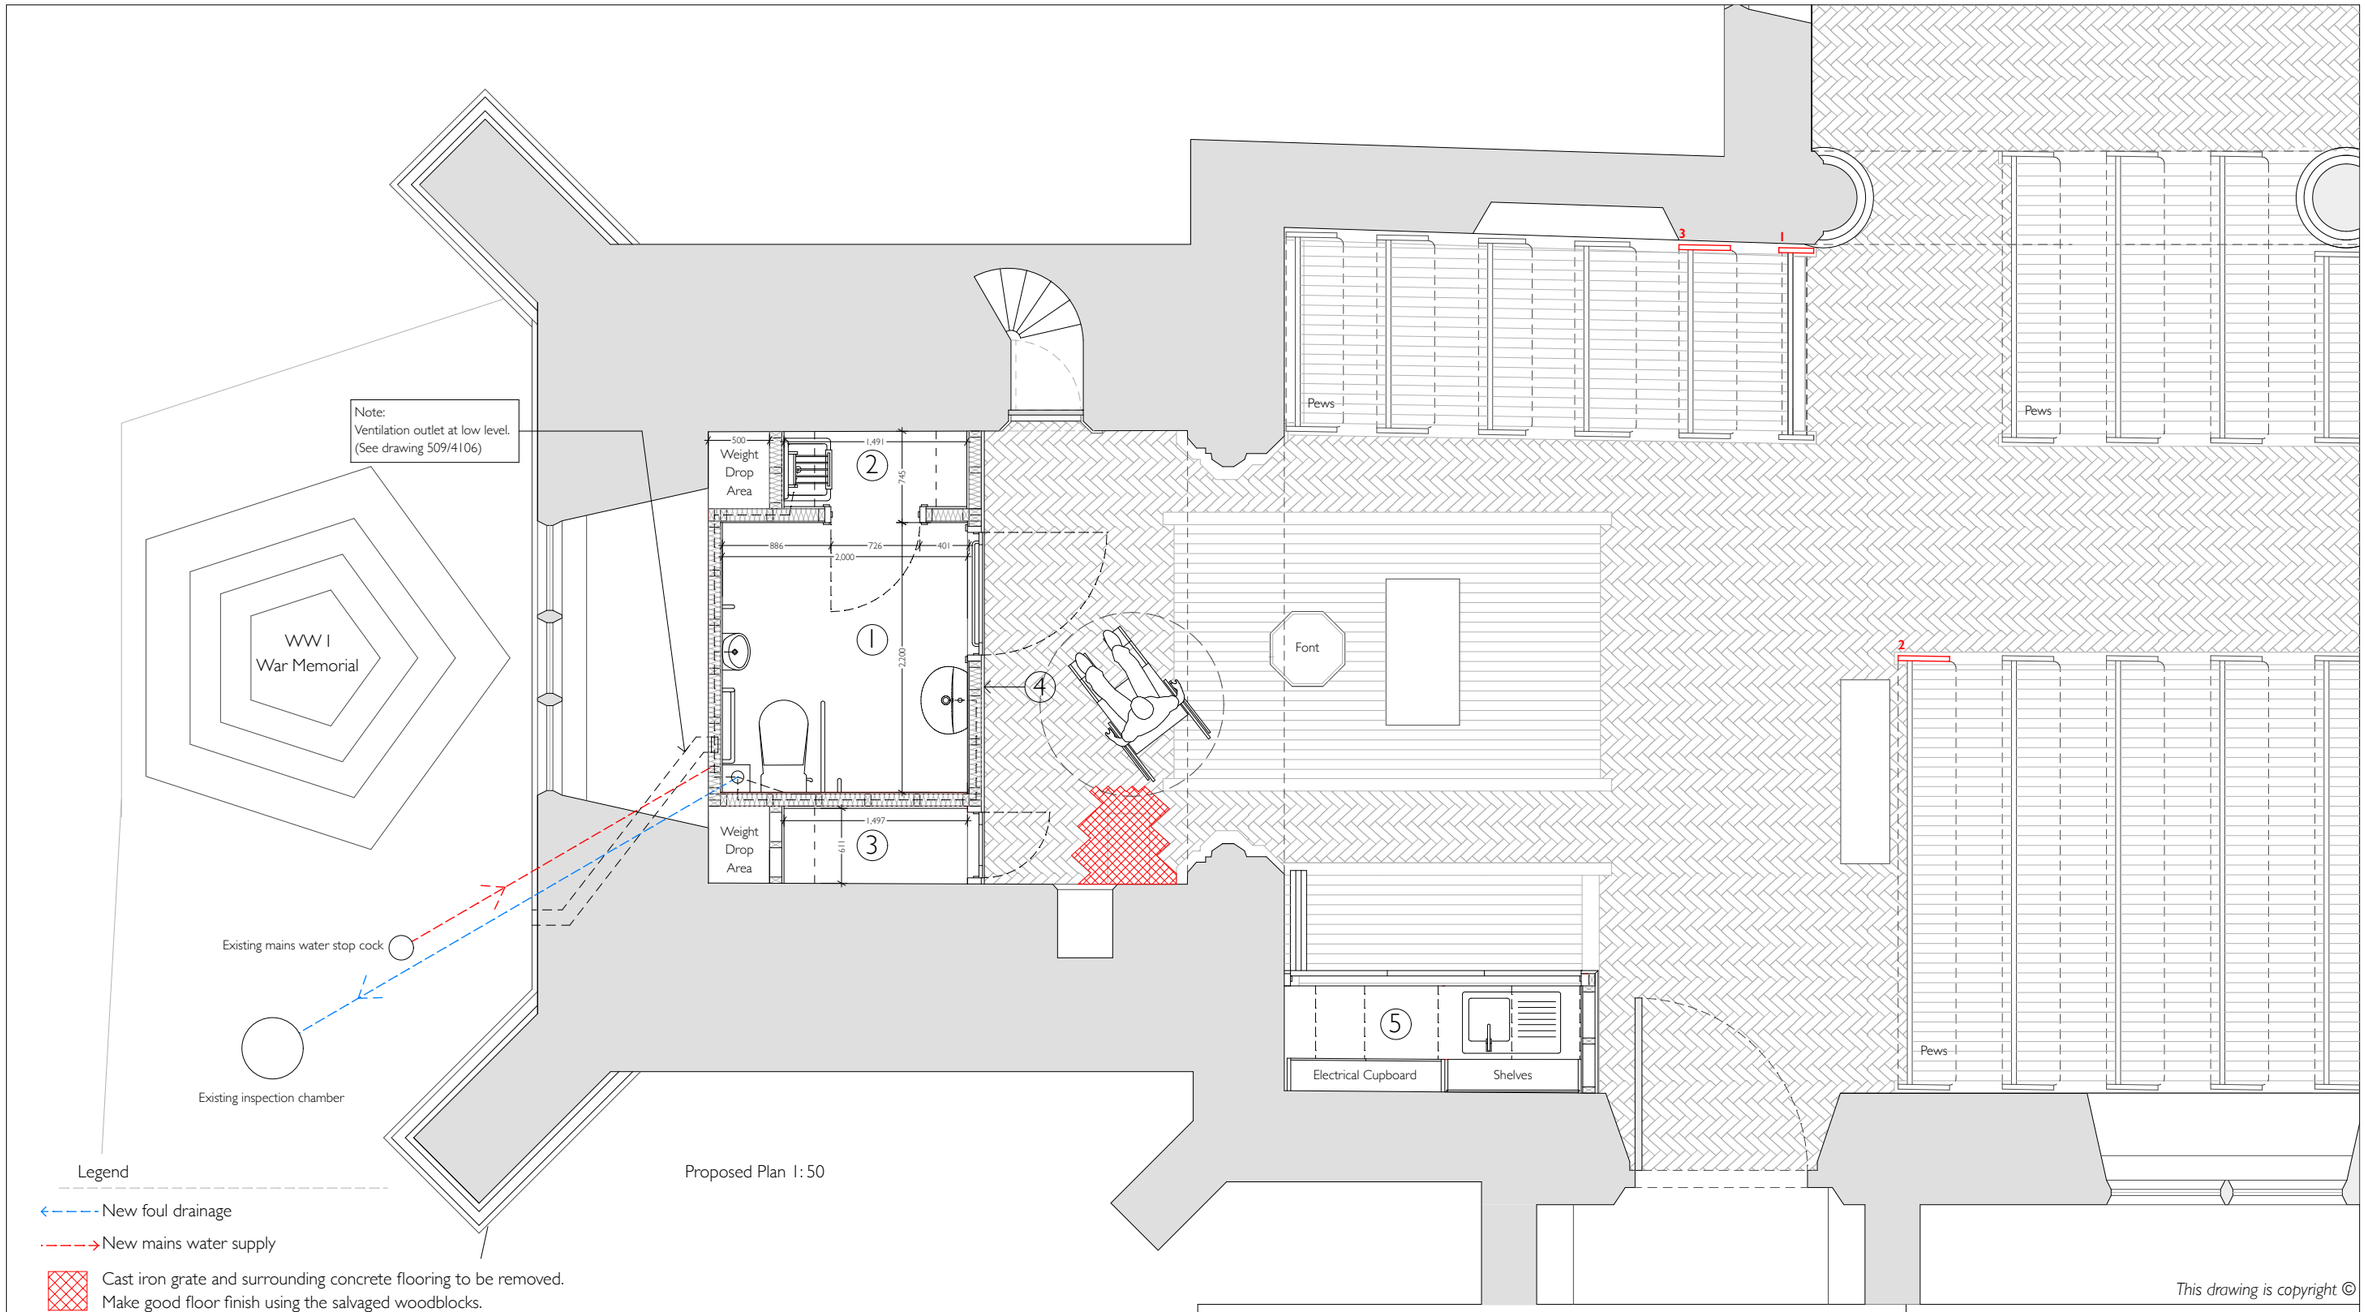

Proposed Plan 1:50

Legend

- New foul drainage
- New mains water supply
- Cast iron grate and surrounding concrete flooring to be removed. Make good floor finish using the salvaged woodblocks.
- 1 The frontal end is to be used to replace the Victorian frontal bench end on the north end of the frontal in the north west corner of the Nave.
- 2 The bench end with the hooded lady is to be used to replace the Victorian poppyhead bench end of the back pew on the south side of the Nave.
- 3 The poppyhead bench end is to be used to replace the Victorian bench end on the north end of the first pew in the north west corner of the Nave.

0.0 0.5 1.0 2.0 3.0 5.0 M

Scope of Works

1 - New Accessible Toilet
2 - New Flower Cupboard with sink and shelves
3 - New Cleaners Cupboard with shelves
4 - New oak screen
5 - New Kitchenette

NORTH

This drawing is copyright ©

Drawing Title
Proposed Ground Floor Plan

Revision		Date
Rev: A	Position of door into flower cupboard amended and door to cleaners cupboard handed.	20/10/2017
Rev: B	Additional dimensions added.	25/10/2017
Rev: C	AS BUILT	19/07/2018

Job №	Dwg №	Rev	Scale		Drawn:MSA
598	/ 4101	C	1:50	@ A3	19 / 10 / 2015

PCC and Churchwardens

New Toilet
Church of All Saints, Weybourne, Norfolk

© Nicholas Warns Architect Ltd.

64 Bishopgate Norwich, NR1 4AA
info@nicholaswarns.com
T: 01603 622056
F: 01603 627 393